

ROUTE ONE SOUTH UTILITY PROJECT


TOWN OF FALMOUTH



US ROUTE 1

INDEX OF SHEETS

Description	Sheet No.
TITLE SHEET	0
LEGEND, NOTES & DETAILS	1
UTILITY PLAN 1 OF 2	2
UTILITY PLAN 2 OF 2	3
UTILITY SERVICE RECONNECT 1 OF 3	4
UTILITY SERVICE RECONNECT 2 OF 3	5
UTILITY SERVICE RECONNECT 3 OF 3	6

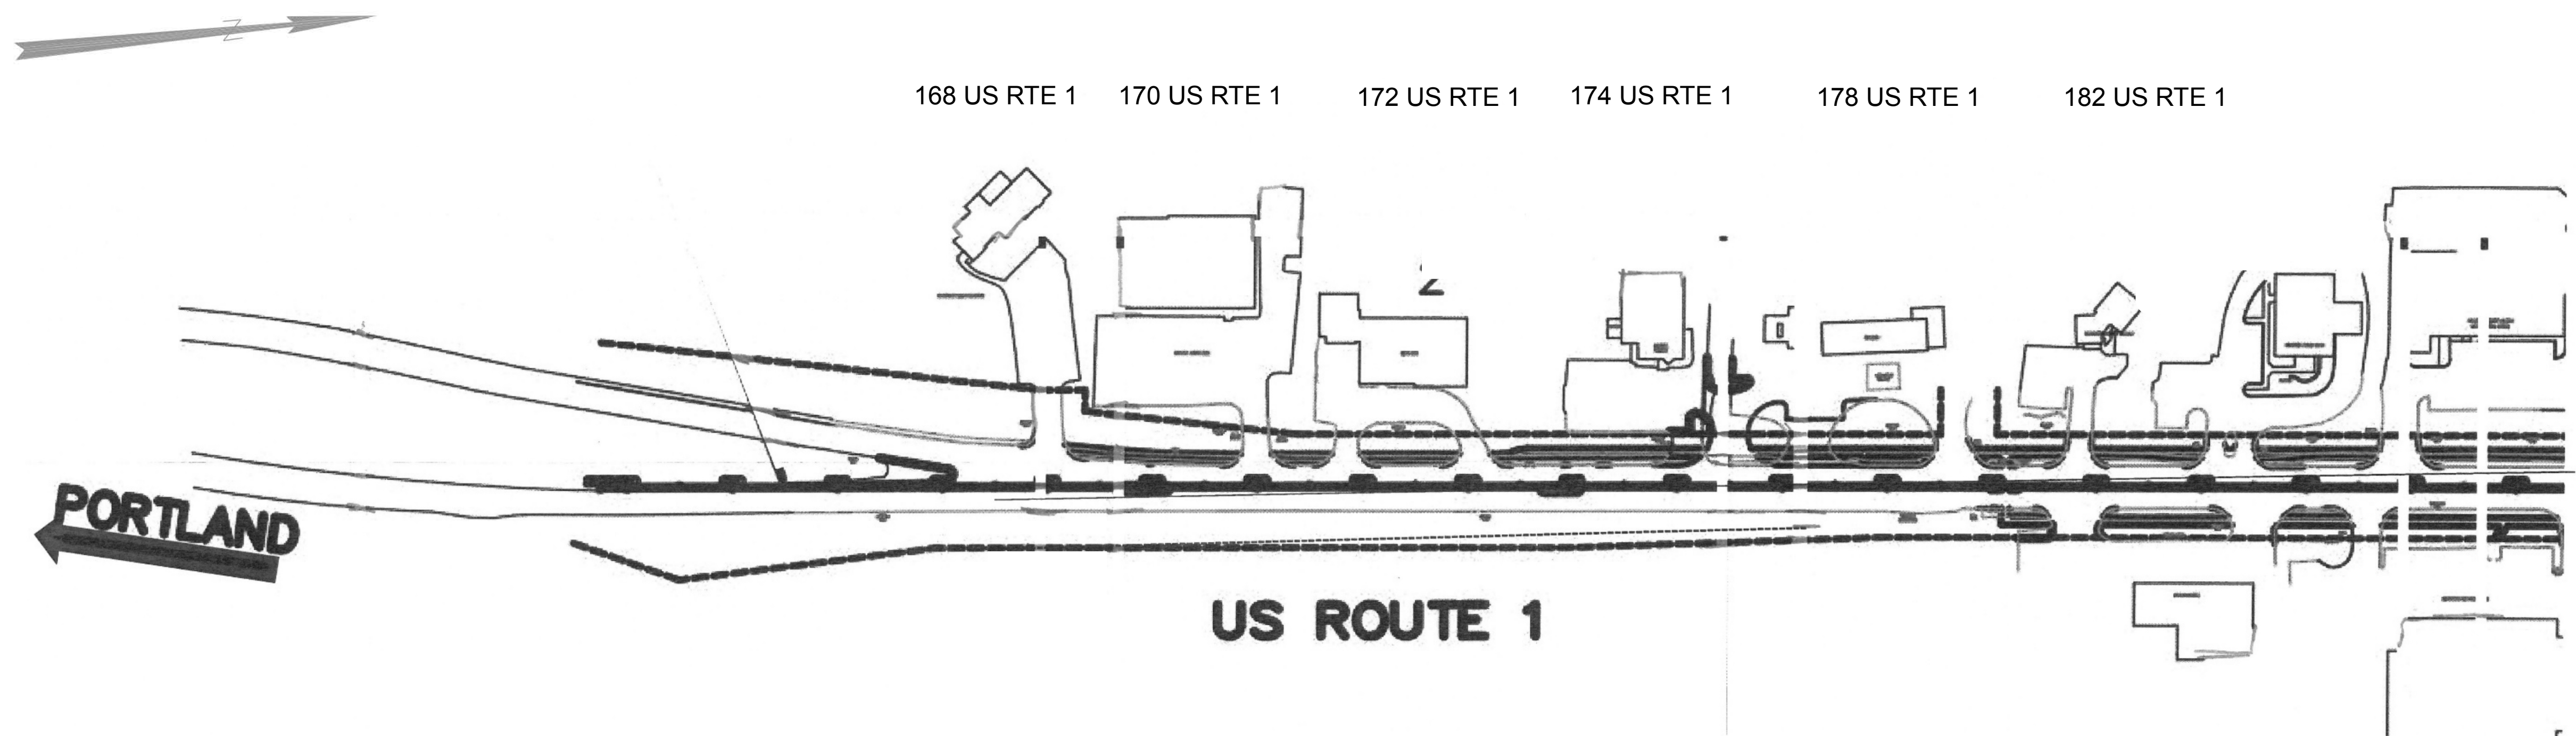

PREPARED BY:

DATE: FEBRUARY 2014

SCALE:

JOB NO. SF-M091

FILE NAME:

REVISIONS

Record Drawing

Revised to Reflect VE Items

ISSUED FOR CONSTRUCTION

DESCRIPTION

REV

3

2

1

REV

DESCRIPTION

REVISIONS

REVISIONS

PROJECT: ROUTE 1 SOUTH UTILITY PROJECT

FALMOUTH, MAINE

TITLE SHEET

TOWN OF FALMOUTH

PREPARED FOR:

PREPARED FOR:

PREPARED FOR:

GENERAL NOTES

- CONDUIT RUNS AND HANDHOLES ARE SHOWN FOR DIAGRAMMATIC PURPOSES ONLY AND SHALL BE ADJUSTED TO MATCH EXISTING AND PROPOSED CONDITIONS AS DIRECTED BY THE RESIDENT ENGINEER.
- THE CONTRACTOR SHALL VISIT THE JOB SITE WITH THE CONTRACT DOCUMENTS AND INVESTIGATE ALL CONDITIONS AFFECTING THIS WORK. THE CONTRACTOR SHALL BE FAMILIAR WITH THE LOCATION AND SITE OF THE WORK, AND SHALL VERIFY DIMENSIONS, QUANTITIES, ACTUAL INSTALLATION CONDITIONS, CONFLICTS, AND STORAGE FACILITIES.
- ALL CONDUIT AND EQUIPMENT TO BE INSTALLED AND GROUNDED IN ACCORDANCE WITH THE LATEST EDITION OF THE NATIONAL ELECTRIC CODE, MAINE ELECTRICAL CODE AND APPLICABLE LOCAL CODES.
- ALL EQUIPMENT AND MATERIALS SHALL BE UL LISTED FOR ITS INTENDED PURPOSE.
- WIRE SIZES SHALL BE BASED ON AMERICAN WIRE GAUGE (AWG), AS APPLIED TO COPPER CONDUCTORS. THE CONDUCTOR INSULATION SHALL BE TYPE THW.
- WIRE AND CABLE FURNISHED AND USED SHALL BE NEW. WIRE AND CABLE SHALL BE PROTECTED FROM WEATHER AND DAMAGE DURING STORAGE AND HANDLING.
- THE CONTRACTOR SHALL ADHERE TO ALL REGULATIONS IMPOSED BY THE MAINE DEPARTMENT OF TRANSPORTATION-HIGHWAY DIVISION.
- ALL WIRE SHALL BE CONTINUOUS WITHOUT RUNNING SPLICES IN CONDUITS. ALL WIRES SHALL EXTEND 24" ABOVE THE PULL BOX, CONNECTED AT ENDS AND ROLLED BACK INTO THE PULL BOX.
- SPLICES SHALL BE RATED AS SUBMERSIBLE.
- THE LOCATIONS OF EXISTING SUBSURFACE UTILITIES SHOWN ON THE PLANS WERE COMPILED FROM AVAILABLE RECORD DRAWINGS AND ARE NOT WARRANTED TO BE CORRECT. THE LOCATIONS ARE APPROXIMATE ONLY AND IN SOME CASES MAY BE INCOMPLETE. THE CONTRACTOR SHALL NOTIFY ALL AGENCIES REQUIRED AND VERIFY THE LOCATION OF ALL EXISTING SUBSURFACE UTILITIES PRIOR TO PERFORMING ANY WORK.
- THE LOCATIONS OF EXISTING FEATURES SHOWN ON THE PLANS, SUCH AS CURB LINES, SIDEWALKS, BRIDGE STRUCTURES, BASELINES, LAYOUT AND STREET LINES, STREET LIGHT POLES AND HANDHOLES, CATCH BASINS, MANHOLES, SIGN POSTS, ETC. WERE COMPILED FROM MAINE DOT RECORD DRAWINGS. THESE FEATURES ARE APPROXIMATE ONLY AND ARE NOT LOCATED AS A RESULT OF A TOPOGRAPHIC/INSTRUMENT SURVEY. THE CONTRACTOR SHALL VERIFY THE LOCATION OF EXISTING FEATURES PRIOR TO PERFORMING ANY WORK.
- PRIOR TO THE INSTALLATION OF PROPOSED UTILITIES, THE CONTRACTOR SHALL EXCAVATE TEST PITS AT LOCATIONS OF UTILITY CROSSINGS TO VERIFY DEPTHS OF EXIST. PIPES, CONDUITS OR OTHER FACILITIES AS DIRECTED BY ENGINEER.
- WHERE A NEW PAVEMENT SHALL MEET EXISTING PAVEMENT, THE JOINT SHALL BE SAWCUT TO A NEAT VERTICAL LINE.
- THE CONTRACTOR SHALL MAINTAIN AREAS IN AND AROUND THE WORK ZONE FREE AND CLEAR OF DEBRIS AT ALL TIMES. NO STOCK PILING OF EQUIPMENT OR MATERIAL SHALL BE PERMITTED OUTSIDE OF FIXED WORK ZONES.
- THE CONTRACTOR SHALL INSTALL OTHER NECESSARY TEMPORARY REGULATORY AND WARNING SIGNS DURING CONSTRUCTION AS DIRECTED BY THE ENGINEER FOR OTHER INCIDENTAL CONSTRUCTION ACTIVITIES. ALL SIGNAGE AND TRAFFIC CONTROL DEVICES USED MUST CONFORM TO THE "MANUAL ON UNIFORM TRAFFIC CONTROL DEVICES", 2003 EDITION.
- FOR CONDUIT TRENCHING DETAILS, REFERENCE THE MAINE STANDARD SPECIFICATIONS SECTION 626-031.
- INSTALL A NYLON PULL STRING IN ALL EMPTY CONDUITS.

ELECTRICAL - GENERAL NOTES

- ALL EXISTING MEDIUM VOLTAGE DEMOLITION TO BE PERFORMED BY CENTRAL MAINE POWER (CMP).
- ALL EXISTING LOW VOLTAGE DEMOLITION PRIOR TO THE POINT OF ATTACHMENT TO BE PERFORMED BY CMP.
- ALL EXISTING LOW VOLTAGE DEMOLITION AFTER THE POINT OF ATTACHMENT TO BE PERFORMED BY THE ELECTRICAL CONTRACTOR.
- FOR TRANSFORMER PAD DETAILS REFERENCE SECTION 908 AND ILLUSTRATIONS 23, 24, 25, & 25 OF THE CENTRAL MAINE POWER HANDBOOK.

TELEPHONE - GENERAL NOTES

- ALL EXISTING TELEPHONE SYSTEM DEMOLITION TO BE PERFORMED BY FAIRPOINT COMMUNICATIONS.
- UNDERGROUND WIRING AND SPLICING PERFORMED BY FAIRPOINT COMMUNICATIONS.

CCTV - GENERAL NOTES

- ALL EXISTING CCTV SYSTEM DEMOLITION TO BE PERFORMED BY TIME WARNER CABLE.
- UNDERGROUND WIRING AND SPLICING PERFORMED BY TIME WARNER CABLE.

COMMUNICATIONS - GENERAL NOTES


- ALL EXISTING COMMUNICATION SYSTEM DEMOLITION TO BE PERFORMED BY OXFORD NETWORKS.
- UNDERGROUND WIRING AND SPLICING PERFORMED BY OXFORD NETWORKS.

LIGHTING LEGEND

	GROUND
	NEW TYPE B1 HANDHOLE (24"x12"x18") FOR USE OFF ROADWAY FOR LIGHTING CONDUIT
	NEW TYPE B2 HANDHOLE (24"x24"x18") FOR USE IN OR OFF ROADWAY FOR LIGHTING CONDUIT
	NEW TRANSFORMER SUPPLIED BY CENTRAL MAINE POWER
	TELEPHONE OR CCTV PEDESTAL
	NEW UTILITY HANDHOLE
	4'(W)x6'(L)x4'(D) ELECTRICAL MANHOLE
	7'(W)x13'(L)x8'(D) TELEPHONE MANHOLE
	4'(W)x6'(L)x4'(D) COMMUNICATIONS MANHOLE
	LOAD CENTER
	UTILITY POLE EXISTING
	UNDERGROUND ELECTRICAL
	OVERHEAD UTILITY
	OXFORD NETWORKS
	TIME WARNER CABLE
	UNDERGROUND TELEPHONE
	OTT COMMUNICATIONS
	PROPERTY LINE

ABBREVIATIONS:

A	AMPERE
AWG	AMERICAN WIRE GAUGE
BRGS	BEARINGS
CKT, CKTS	CIRCUIT, CIRCUITS
C	CONDUIT
CCTV	CLOSED CIRCUIT TELEVISION
CEM	CEMENT
CONC	CONCRETE
CONN.	CONNECTOR
DIA	DIAMETER
EB	EASTBOUND
ELEC.	ELECTRIC
EMH	ELECTRIC MANHOLE
EOP	EDGE OF PAVEMENT
EXP	EXPANSION
FC	FAIRPOINT COMMUNICATIONS
G	GROUND
GFCI	GROUND FAULT CIRCUIT INTERRUPTER
HH	HANDHOLE
HLLC	HIGHWAY LIGHTING LOAD CENTER
HMA	HOT MIX ASPHALT
ITS	INTELLIGENT TRANSPORTATION SYSTEM
LC	LIGHTING CIRCUIT
MIN.	MINIMUM
NB.	NORTHBOUND
O	ORANGE
OD	OUTER DIAMETER
O.C.	ON CENTER
OHU	OVERHEAD UTILITY
ON	OXFORD NETWORKS
PROP	PROPOSED
P	POLE
PVC	POLYVINYL CHLORIDE
R&D	REMOVE AND DISPOSE
R&T	REMOVE AND TRANSPORT
RC	RECEPTACLE CIRCUIT
RM	RIGID METAL
RGS	RIGID GALVANIZED STEEL
RTE	ROUTE
SDWK	SIDEWALK
SPST	SINGLE POLE SINGLE THROW
SPDT	SINGLE POLE DOUBLE THROW
SB.	SOUTHBOUND
TWC	TIME WARNER CABLE
TYP.	TYPICAL
UGE	UNDERGROUND ELECTRICAL
UGT	UNDERGROUND TELEPHONE
VMS	VARIABLE MESSAGE SIGN
V	VOLT
WB.	WESTBOUND
W	WATT / WHITE-NEUTRAL
W/	WITH

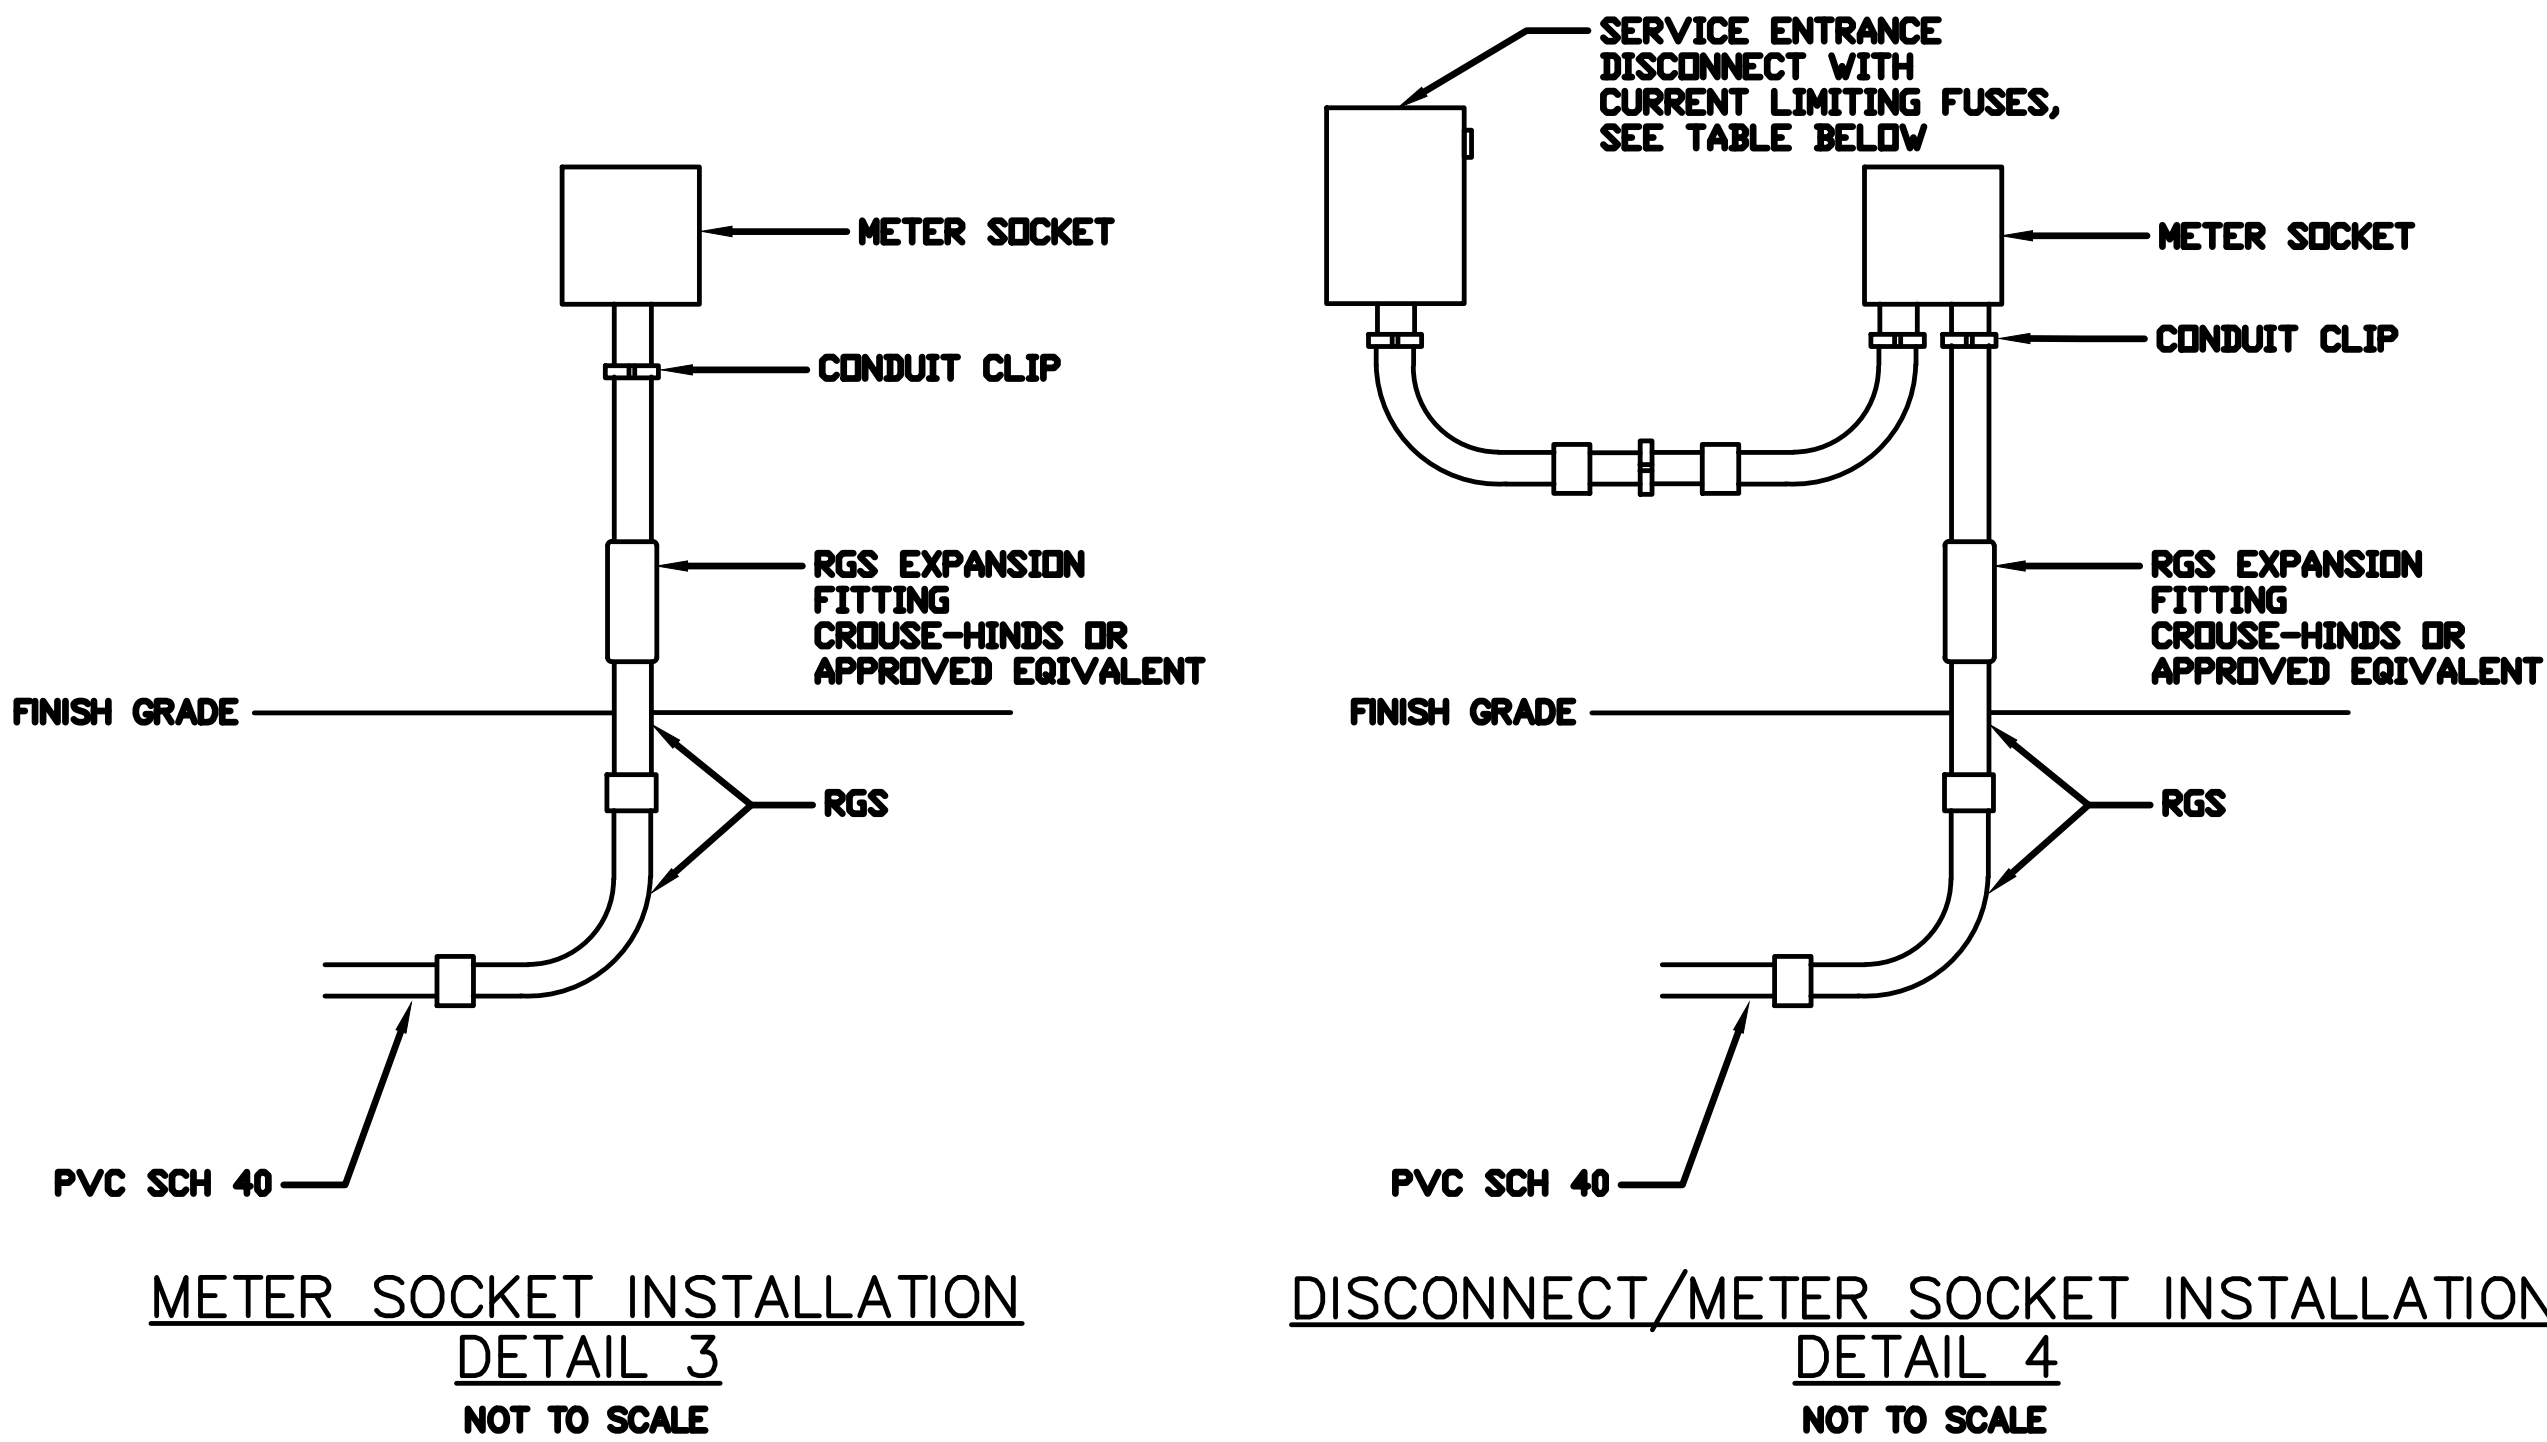

PROPERTY	COOPER BUSSMAN CAT. #
A PERFECT SMILE - 188 U.S. ROUTE 1	LPJ_SP - 200A
FALMOUTH PHYSICAL THERAPY - 182 U.S. ROUTE 1	LPJ_SP - 100A

Stantec

462 Poyne Road Scarborough, Court
Scarborough, Maine 04074-4979
Tel: 207.886.8800
www.stantec.com

PREPARED BY:

DATE: NOV. 2017

SCALE: NOT TO SCALE

JOB NO. SF-M091

FILE NAME:

PROJECT: ROUTE 1 SOUTH UTILITY PROJECT
FALMOUTH, MAINE

SHEET TITLE: LEGEND, NOTES & DETAILS

PREPARED FOR: TOWN OF FALMOUTH

REV

DATE


DESCRIPTION

REVISIONS


SHEET NUMBER

1

OF 6

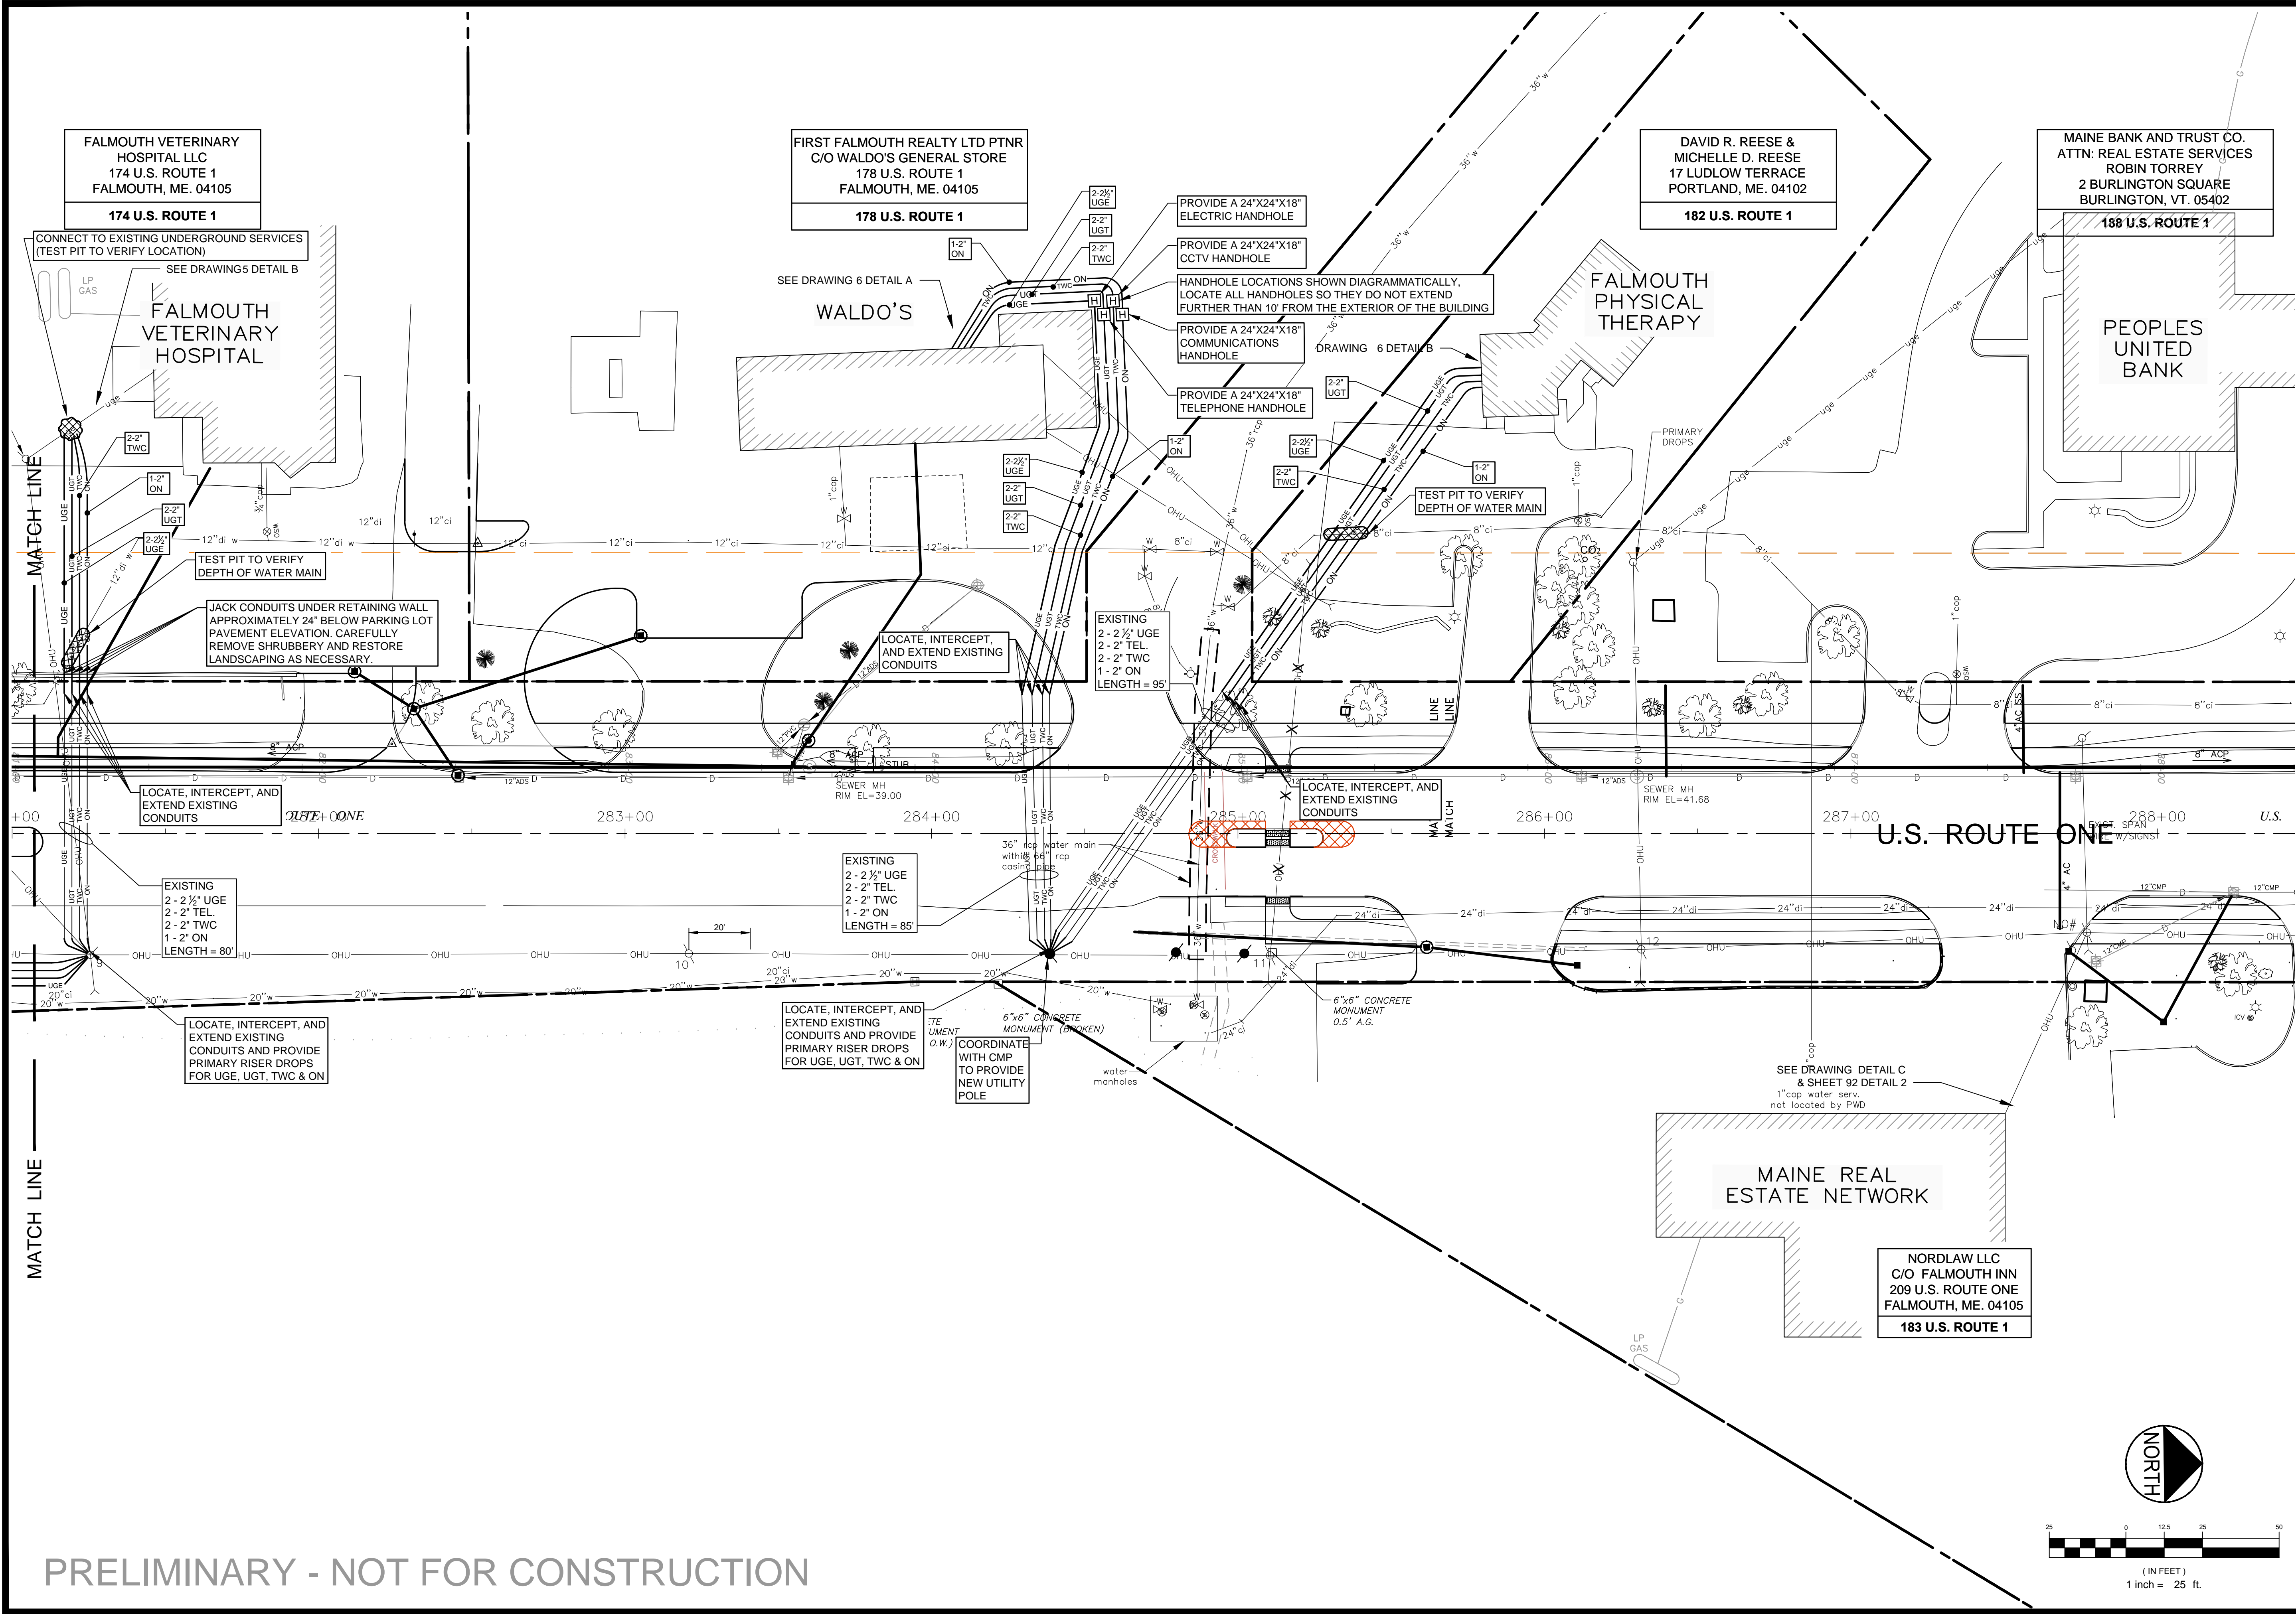

PRELIMINARY - NOT FOR CONSTRUCTION

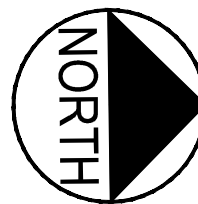

PROJECT: ROUTE 1 SOUTH UTILITY PROJECT
FALMOUTH, MAINE

SHEET TITLE: UTILITY PLAN 2 OF 2

PREPARED FOR: TOWN OF FALMOUTH

PREPARED BY: Stantec

DATE: NOV. 2017

SCALE: 1" = 25'

JOB NO. SF-M091

FILE NAME: SF-M091-UTILITY-CMP

REV

DATE

DESCRIPTION

REVISIONS

SHEET NUMBER

3

OF 6

A photograph of a residential street in winter. A tall utility pole stands on the right side of the road, with bare tree branches hanging over it. The ground is covered in patches of snow and bare grass. In the background, there are more trees and a cloudy sky.



1. INTERCEPT THE EXISTING FEEDER AT THE TEST PIT AND INSTALL A 24"x24"x18" HANDHOLE.
2. RUN (2) 2-1/2" SCHEDULE 40 PVC CONDUITS AT A DEPTH OF 24" FROM THE SECONDARY SIDE OF THE NEW CMP PAD MOUNTED TRANSFORMER TO THE NEW HANDHOLE.
3. THE FIRST 2-1/2" CONDUIT WILL CONTAIN (3) 3/0 AWG CU CONDUCTORS AND (1) #4 AWG CU GROUND AND WILL BE CONNECTED TO THE EXISTING SERVICE ENTRANCE CONDUCTORS WITH SUBMERSIBLE RATED SPLICE KITS. SPLICE KITS SHALL BE SUITABLE FOR CONNECTING COPPER TO ALUMINUM CONDUCTORS.
4. THE SECOND CONDUIT IS SPARE FOR FUTURE USE. INSTALL A NYLON PULL STRING AND CAP THE CONDUIT WITHIN THE HANDHOLE.

1. LOCATE THE EXISTING TELEPHONE SERVICE AT THE TEST PIT AND INSTALL A 24"x24"x18" HANDHOLE.
2. RUN (2) 2" PVC CONDUITS FROM THE TELEPHONE PEDESTAL LOCATED ADJACENT TO THE NEW PAD MOUNT TRANSFORMER TO THE NEW HANDHOLE. EACH OF THE CONDUITS SHALL CONTAIN A NYLON PULL STRING.
3. WIRING AND SPLICING BY OTHERS.

1. LOCATE THE EXISTING CCTV SERVICE AT THE TEST PIT AND INSTALL A 24"x24"x18" HANDLE.
2. RUN (2) 2" PVC CONDUITS FROM THE CCTV PEDESTAL LOCATED ADJACENT TO THE NEW PAD MOUNT TRANSFORMER TO THE NEW HANDLE. EACH OF THE CONDUITS SHALL CONTAIN A NYLON PULL STRING.
3. WIRING AND SPLICING BY OTHERS.

1. LOCATE THE END OF THE EXISTING 2" CONDUIT CROSSING THE ROADWAY AND EXTEND INTO A NEW 24"x24"x18" COMMUNICATIONS HANDHOLE ADJACENT TO THE NEW PAD MOUNTED TRANSFORMER.

CORE THROUGH WALL INTO CONFERENCE ROOM DROP CEILING SPACE, TYPICAL FOR ALL NEW CONDUITS.



1. THERE IS AN EXISTING CMP PAD MOUNT TRANSFORMER THAT IS TO BE REUSED. NO ELECTRICAL WORK REQUIRED ON THE SECONDARY SIDE OF THE TRANSFORMER.

1. RUN (1) 2" PVC CONDUITS FROM THE NEW 24"x24"x18" TELEPHONE HANDHOLE TO THE BUILDING.
2. TURN THE CONDUIT UP, CORE THROUGH THE EXTERIOR WALL OF THE BUILDING, AND STUB OUT INTO THE CONFERENCE ROOM DROP CEILING SPACE INSIDE. INSTALL A NYLON PULL STRING AND CAP CONDUIT. SEAL CONDUIT PENETRATION WITH HIGH STRENGTH, NON-SHRINK GROUT.

1. RUN (1) 2" PVC CONDUITS FROM THE NEW 24"x24"x18" CCTV HANDHOLE TO THE BUILDING.
2. TURN THE CONDUIT UP, CORE THROUGH THE EXTERIOR WALL OF THE BUILDING, AND STUB OUT INTO THE CONFERENCE ROOM DROP CEILING SPACE INSIDE. INSTALL A NYLON PULL STRING AND CAP CONDUIT.



1. RUN (1) 2" PVC CONDUITS FROM THE NEW 24"x24"x18" COMMUNICATIONS HANDHOLE TO THE BUILDING.
2. TURN THE CONDUIT UP, CORE THROUGH THE EXTERIOR WALL OF THE BUILDING, AND STUB OUT INTO THE CONFERENCE ROOM DROP CEILING SPACE INSIDE. INSTALL A NYLON PULL STRING AND CAP CONDUIT.

1. FOR LEGEND, ABBREVIATIONS, AND GENERAL NOTES SEE DRAWING 1.

DRAWN:	TJM	DATE:	NOV. 2017
DESIGNED:	TJM	SCALE:	NOT TO SCALE
CHECKED:	DMG	JOB NO.	SF-M091
FILE NAME:			

PROJECT:	ROUTE 1 SOUTH UTILITY PROJECT FALMOUTH, MAINE				
SHEET TITLE:	UTILITY SERVICE RECONNECT 1 OF 3				
PREPARED FOR:	TOWN OF FALMOUTH				
	REV	DATE	DESCRIPTION	P.E.	
			REVISIONS	LIC. #	

DETAIL A
172 U.S. ROUTE 1
SIMPLY HOME



ELECTRICAL

1. LOCATE THE END OF THE (2) EXISTING 2-1/2" CONDUITS CROSSING THE ROADWAY AND EXTEND (2) 2-1/2" SCHEDULE 40 PVC CONDUITS AT A DEPTH OF 24" TO THE LOCATION OF THE METER SOCKET.
4. THE FIRST 2-1/2" CONDUIT WILL CONTAIN (3) 250 KCMIL CU CONDUCTORS AND (1) #2 AWG CU GROUND. AFTER STUBBING OUT OF THE GROUND, CHANGE THE CONDUIT TO RGS AND ENTER THE BOTTOM OF A NEW BOTTOM FED METER SOCKET. SEE SHEET 1 DETAIL 3. TERMINATE THE WIRING IN THE NEW METER SOCKET. TERMINATE THE EXISTING SERVICE ENTRANCE CONDUCTORS IN THE NEW METER SOCKET.
5. THE SECOND 2-1/2" CONDUIT IS SPARE FOR FUTURE USE. INSTALL A NYLON PULL STRING, SECURE THE CONDUIT TO THE FACE OF THE BUILDING AND CAP THE CONDUIT.

TELEPHONE

1. LOCATE THE END OF THE (2) EXISTING 2" CONDUITS CROSSING THE ROADWAY AND EXTEND (2) 2" PVC CONDUITS TO THE BUILDING. EACH OF THE CONDUITS SHALL CONTAIN A NYLON PULL STRING. LOCATE 2' TO THE LEFT OF THE ELECTRICAL METER SOCKET.
2. SECURE THE CONDUITS TO THE FACE OF THE BUILDING AND CAP OFF.

CCTV

1. LOCATE THE END OF THE (2) EXISTING 2" CONDUITS CROSSING THE ROADWAY AND EXTEND (2) 2" PVC CONDUITS TO THE BUILDING. EACH OF THE CONDUITS SHALL CONTAIN A NYLON PULL STRING. LOCATE 2' TO THE LEFT OF THE NEW TELEPHONE SERVICE.
2. SECURE THE CONDUITS TO THE FACE OF THE BUILDING AND CAP OFF.

COMMUNICATIONS

1. LOCATE THE END OF THE (1) EXISTING 2" CONDUIT CROSSING THE ROADWAY AND EXTEND (1) 2" PVC CONDUIT TO THE BUILDING. THE CONDUIT SHALL CONTAIN A NYLON PULL STRING. LOCATE 2' TO THE LEFT OF THE NEW CCTV SERVICE.
2. SECURE THE CONDUIT TO THE FACE OF THE BUILDING AND CAP OFF.

DETAIL B
174 U.S. ROUTE 1
FALMOUTH VETERINARY HOSPITAL



ELECTRICAL

1. INTERCEPT THE EXISTING FEEDER IN THE VICINITY OF THE UTILITY POLE AND INSTALL A 24"x24"x18" HANDHOLE.
2. LOCATE THE END OF THE (2) EXISTING 2-1/2" CONDUITS CROSSING THE ROADWAY AND EXTEND (2) 2-1/2" SCHEDULE 40 PVC CONDUITS TO THE NEW HANDHOLE AT A DEPTH OF 24".
3. THE FIRST 2-1/2" CONDUIT WILL CONTAIN (3) 250 KCMIL CU CONDUCTORS AND (1) #2 AWG CU GROUND AND WILL BE CONNECTED TO THE EXISTING SERVICE ENTRANCE CONDUCTORS WITH SUBMERSIBLE RATED SPLICE KITS. SPLICE KITS SHALL BE SUITABLE FOR CONNECTING COPPER TO ALUMINUM CONDUCTORS.
4. THE SECOND CONDUIT IS SPARE FOR FUTURE USE. INSTALL A NYLON PULL STRING AND CAP THE CONDUIT

TELEPHONE

1. LOCATE THE EXISTING TELEPHONE SERVICE AT THE TEST PIT AND INSTALL A 24"x24"x18" HANDOLE.
2. LOCATE THE END OF THE (2) EXISTING 2" CONDUITS CROSSING THE ROADWAY AND EXTEND (2) 2" PVC CONDUITS TO THE NEW HANDHOLE. EACH OF THE CONDUITS SHALL CONTAIN A NYLON PULL STRING.
3. WIRING AND SPLICING BY OTHERS.

CCTV

1. LOCATE THE EXISTING CCTV SERVICE AT THE TEST PIT AND INSTALL A 24"x24"x18" HANDOLE.
2. LOCATE THE END OF THE (2) EXISTING 2" CONDUITS CROSSING THE ROADWAY AND EXTEND (2) 2" PVC CONDUITS TO THE NEW HANDHOLE. EACH OF THE CONDUITS SHALL CONTAIN A NYLON PULL STRING.
3. WIRING AND SPLICING BY OTHERS.

COMMUNICATIONS

1. LOCATE THE EXISTING COMMUNICATIONS SERVICE AT THE TEST PIT AND INSTALL A 24"x24"x18" COMMUNICATIONS HANDHOLE.
2. LOCATE THE END OF THE (1) EXISTING 2" CONDUIT CROSSING THE ROADWAY AND EXTEND (1) 2" PVC CONDUIT TO THE NEW HANDHOLE. THE CONDUIT SHALL CONTAIN A NYLON PULL STRING.
3. WIRING AND SPLICING BY OTHERS.

GENERAL NOTES

1. FOR LEGEND, ABBREVIATIONS, AND GENERAL NOTES SEE DRAWING 1.

5 OF 6	PROJECT:		ROUTE 1 SOUTH UTILITY PROJECT FALMOUTH, MAINE					PREPARED BY: <div>Stantec 462 Payne Road Scarborough Court Scarborough, Maine 04074-4929 Tel: 207.883.3355 www.stantec.com</div>
	SHEET TITLE:		UTILITY SERVICE RECONNECT 2 OF 3					
	PREPARED FOR:		TOWN OF FALMOUTH					
	REV	DATE	DESCRIPTION	P.E.				
			REVISIONS	LIC. #				

SHEET NUMBER

DETAIL A
178 U.S. ROUTE 1
WALDOS CITGO

DETAIL B
182 U.S. ROUTE 1
FALMOUTH PHYSICAL THERAPY



ELECTRICAL

1. LOCATE THE END OF THE (2) EXISTING 2-1/2" CONDUITS CROSSING THE ROADWAY AND EXTEND (2) 2-1/2" SCHEDULE 40 PVC CONDUITS TO A NEW 24"x24"x18" HANDHOLE. EXTEND (2) 2-1/2" SCHEDULE 40 PVC CONDUITS FROM THE NEW HANDHOLE TO THE LOCATION OF THE METER SOCKET.
2. THE FIRST 2-1/2" CONDUIT WILL CONTAIN (3) 250 KCMIL CU CONDUCTORS AND (1) #2 AWG CU GROUND. AFTER STUBBING OUT OF THE GROUND, CHANGE THE CONDUIT TO RGS AND ENTER THE BOTTOM OF A NEW BOTTOM FED METER SOCKET. SEE SHEET 1 DETAIL 3. TERMINATE WIRING IN THE NEW METER SOCKET. TERMINATE EXISTING SERVICE ENTRANCE CONDUCTORS IN THE NEW METER SOCKET.
3. THE SECOND 2-1/2" CONDUIT IS A SPARE FOR FUTURE USE. AFTER STUBBING OUT OF THE GROUND, CHANGE CONDUIT TO RGS, SECURE TO THE BUILDING, INSTALL A NYLON PULL STRING AND CAP THE CONDUIT.
4. DEMOLISH ALL SERVICE ENTRANCE CONDUIT AND CONDUCTORS FROM THE POINT OF ATTACHMENT TO THE METER SOCKET AND FILL ALL HOLES REMAINING FROM CONDUIT STRAPS.



TELEPHONE

1. LOCATE THE END OF THE (2) EXISTING 2" CONDUITS CROSSING THE ROADWAY AND EXTEND (2) 2" PVC CONDUITS TO A NEW 24"x24"x18" HANDHOLE. EXTEND (2) 2" PVC COUNDITS FROM THE NEW HANDHOLE TO THE BUILDING. EACH OF THE CONDUITS SHALL CONTAIN A NYLON PULL STRING. LOCATE 2' TO THE LEFT OF THE ELECTRICAL METER SOCKET.
2. SECURE THE CONDUITS TO THE FACE OF THE BUILDING AND CAP OFF.

CCTV

1. LOCATE THE END OF THE (2) EXISTING 2" CONDUITS CROSSING THE ROADWAY AND EXTEND (2) 2" PVC CONDUITS TO A NEW 24"x24"x18" HANDHOLE. EXTEND (2) 2" PVC COUNDITS FROM THE NEW HANDHOLE TO THE BUILDING. EACH OF THE CONDUITS SHALL CONTAIN A NYLON PULL STRING. LOCATE 2' TO THE LEFT OF THE NEW TELEPHONE SERVICE.
2. SECURE THE CONDUITS TO THE FACE OF THE BUILDING AND CAP OFF.

COMMUNICATIONS

1. LOCATE THE END OF THE (2) EXISTING 2" CONDUITS CROSSING THE ROADWAY AND EXTEND (2) 2" PVC CONDUITS TO A NEW 24"x24"x18" HANDHOLE. EXTEND (2) 2" PVC COUNDITS FROM THE NEW HANDHOLE TO THE BUILDING. EACH OF THE CONDUITS SHALL CONTAIN A NYLON PULL STRING. LOCATE 2' TO THE LEFT OF THE NEW CCTV SERVICE.
2. SECURE THE CONDUITS TO THE FACE OF THE BUILDING AND CAP OFF.



ELECTRICAL

1. LOCATE THE END OF THE (2) EXISTING 2-1/2" CONDUITS CROSSING THE ROADWAY AND EXTEND (2) 2-1/2" SCHEDULE 40 PVC CONDUITS TO TO THE LOCATION OF THE METER SOCKET.
2. THE FIRST 2-1/2" CONDUIT WILL CONTAIN (3) #2/0 AWG CU CONDUCTORS AND (1) #4 AWG CU GROUND. AFTER STUBBING OUT OF THE GROUND, CHANGE THE CONDUIT TO RGS AND ENTER THE BOTTOM OF A NEW BOTTOM FED METER SOCKET. TERMINATE THE WIRING IN THE NEW METER SOCKET. TERMINATE THE EXISTING SERVICE ENTRANCE CONDUCTORS IN THE NEW METER SOCKET.
3. THE SECOND 2-1/2" CONDUIT IS A SPARE FOR FUTURE USE. AFTER STUBBING OUT OF THE GROUND, CHANGE CONDUIT TO RGS, SECURE TO THE BUILDING, INSTALL A NYLON PULL STRING AND CAP THE CONDUIT.
4. INSTALL A 100A FUSED DISCONNECT WITH CURRENT LIMITING FUSES ON THE LOAD SIDE OF THE METER SOCKET. SEE SHEET 1 DETAIL 4.



TELEPHONE

1. LOCATE THE END OF THE (2) EXISTING 2" CONDUITS CROSSING THE ROADWAY AND EXTEND (2) 2" PVC CONDUITS TO THE BUILDING. EACH OF THE CONDUITS SHALL CONTAIN A NYLON PULL STRING. LOCATE 2' TO THE LEFT OF THE ELECTRICAL METER SOCKET.
2. SECURE THE CONDUITS TO THE FACE OF THE BUILDING AND CAP OFF.

CCTV

1. LOCATE THE END OF THE (2) EXISTING 2" CONDUITS CROSSING THE ROADWAY AND EXTEND (2) 2" PVC CONDUITS TO THE BUILDING. EACH OF THE CONDUITS SHALL CONTAIN A NYLON PULL STRING. LOCATE 2' TO THE LEFT OF THE NEW TELEPHONE SERVICE.
2. SECURE THE CONDUITS TO THE FACE OF THE BUILDING AND CAP OFF.

COMMUNICATIONS

1. LOCATE THE END OF THE (1) EXISTING 2" CONDUIT CROSSING THE ROADWAY AND EXTEND (1) 2" PVC CONDUIT TO THE BUILDING. THE CONDUIT SHALL CONTAIN A NYLON PULL STRING. LOCATE 2' TO THE LEFT OF THE NEW CCTV SERVICE.
2. SECURE THE CONDUIT TO THE FACE OF THE BUILDING AND CAP OFF.

GENERAL NOTES

1. FOR LEGEND, ABBREVIATIONS, AND GENERAL NOTES SEE DRAWING 1.

OF 6	SHEET NUMBER	PROJECT:		ROUTE 1 SOUTH UTILITY PROJECT FALMOUTH, MAINE		PREPARED BY: <div>Stantec 482 Payne Road Scarborough Court Scarborough, Maine 04074-4979 Tel.: 207.863.3355 www.stantec.com</div>							
		SHEET TITLE:		UTILITY SERVICE RECONNECT 3 OF 3			DRAWN: TJM		DATE: NOV. 2017				
							DESIGNED: TJM		SCALE: NOT TO SCALE				
							CHECKED: DMG		JOB NO.: SF-M091				
		PREPARED FOR:		TOWN OF FALMOUTH			REV.		DATE		DESCRIPTION		P.E.
										REVISIONS		LIC. #	

SHEET NUMBER